


GRUNDRISS 1:100 EG.

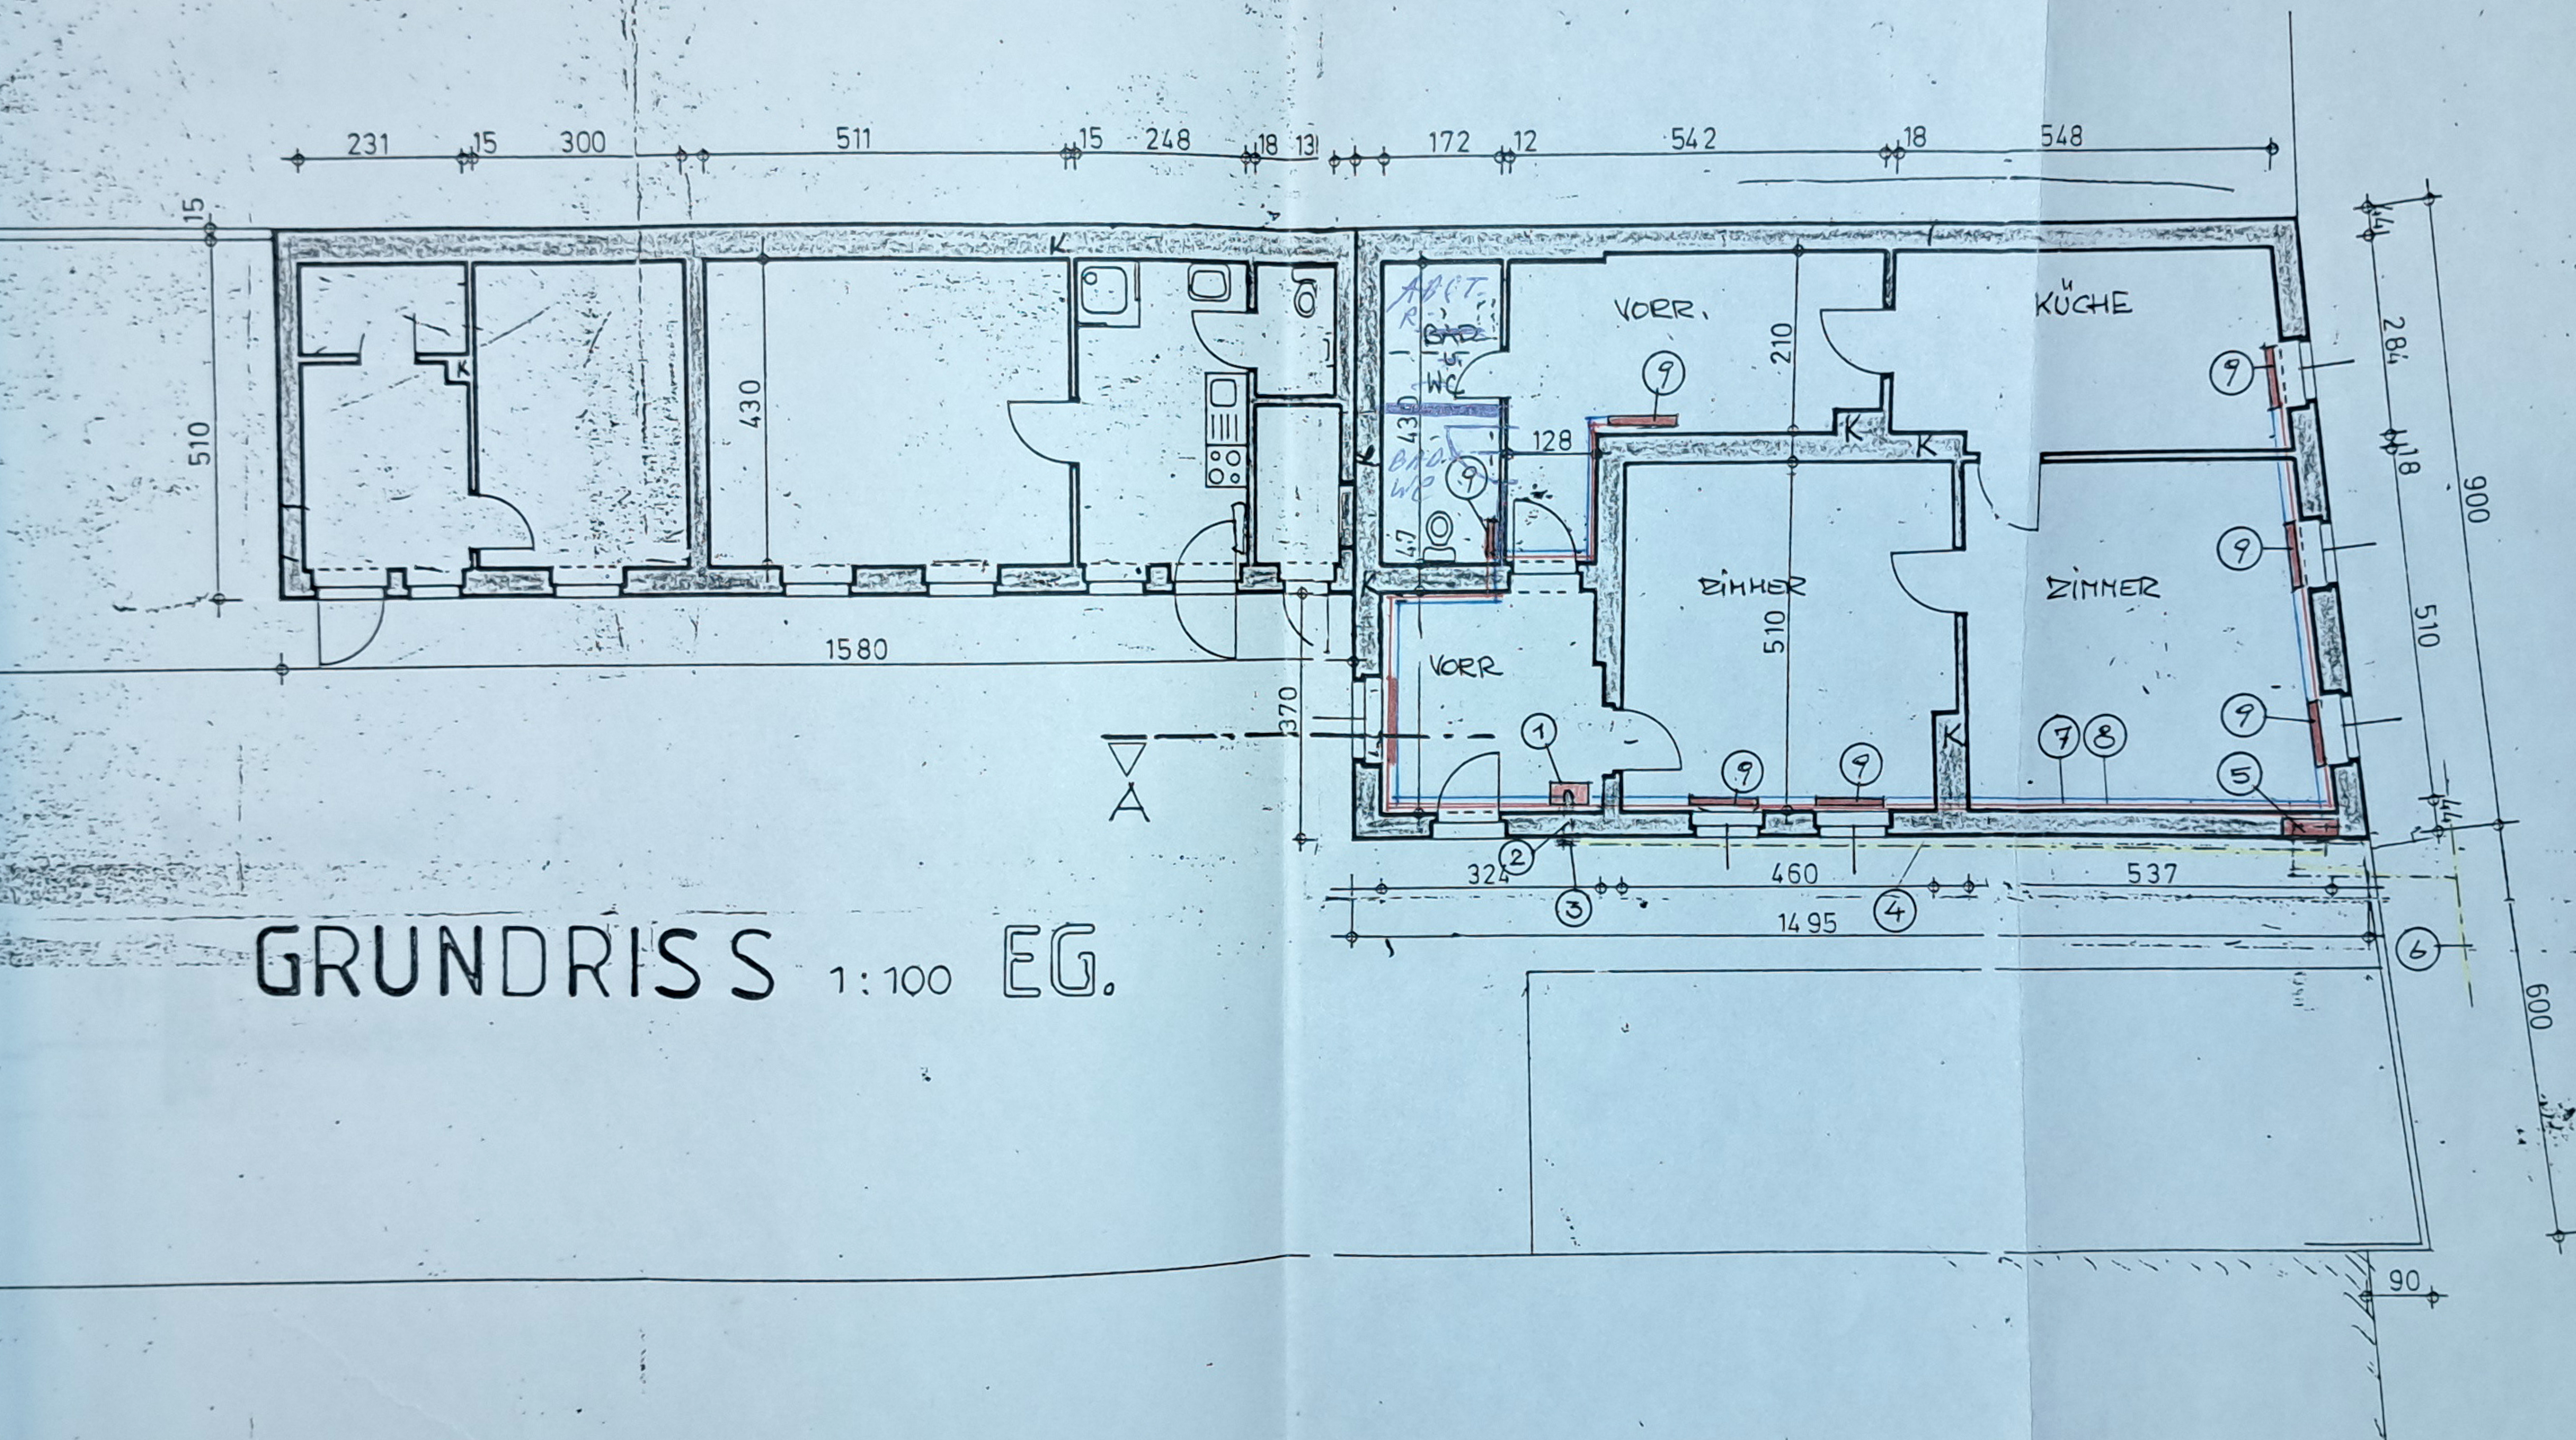

BESTANDSPLAN MET: 1:100

PAULINERFELDSTR. 10